Update effective January 1, 2015 - This manual may be used as a reference by a STS designer when specifying standards for construction, installation notes and certain aggregate materials for STS components. STS designers are not be required to use this manual. When used, if conflicts exist between this manual and Ohio Administrative Code 3701-29, the state code shall prevail. STS contactors shall follow the approved STS design.

23 Appendix 23.0 As-Builts & Layout Surveys

Update effective January 1, 2015 - This manual may be used as a reference by a STS designer when specifying standards for construction, installation notes and certain aggregate materials for STS components. STS designers are not be required to use this manual. When used, if conflicts exist between this manual and Ohio Administrative Code 3701-29, the state code shall prevail. STS contactors shall follow the approved STS design.

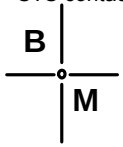

Benchmark

B.S. Backsight

F.S. Foresight

H.I. Height of Instrument

Instrument Set-up Location

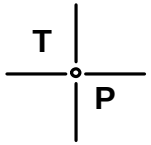

Turning Point

(3 - 2) Existing (Natural) Elevation

Pressure/Gravity Pipe

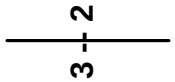

Top of Pipe

Spot Grade Rod Reading*

*Spot grades are to be used with the following prefixes and suffixes to indicate item being surveyed.

Prefixes:
- EX - Existing
- PL - Planned
- AB - As-Built

Suffixes:
- D.B. - Ditch Bottom (Ditch Invert)
- T.G. - Top of Gravel
- T.S. - Top of Sand
- F.L. - Flow Line(Pipe Invert)
- T.T. - Top of Tank
- T.R. - Top of Riser
- T.P. - Top of Pipe

Example:

AB 3 - 2 TT

Interpretation: As-Built Spot Elevation Shot for Top of Tank ; Grade Rod Reading of 3 ft - 2 in.

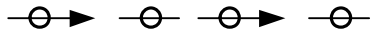

Gradient Drain

Gradient Drain Sump Basin or Pump Basin

 

Buried Electric Service

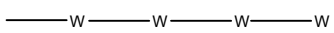

Buried Water Service

Structure (Building)

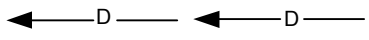

Diversion Ditch

Control Panel

Electrical Disconnect

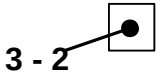

Top of Drop Box

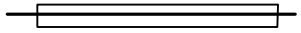

Cased Pipe

Tank

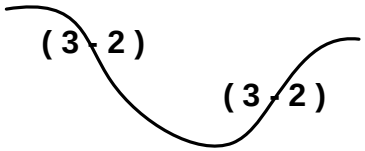

Contour

HAMILTON COUNTY GENERAL HEALTH DISTRICT
Division of Water Quality

Symbols for "Layout Surveys" and "As-Builts"

Title: Symbols for "Layout Surveys" and "As-Builts"		
Drawn By: CMG	Date: 2/2/05	Revision #: 3.0

Update effective January 1, 2015 - This manual may be used as a reference by a STS designer when specifying standards for construction, installation notes and certain aggregate materials for STS components. STS designers are not be required to use this manual. When used, if conflicts exist between this manual and Ohio Administrative Code 3701-29, the state code shall prevail. STS contactors shall follow the approved STS design.
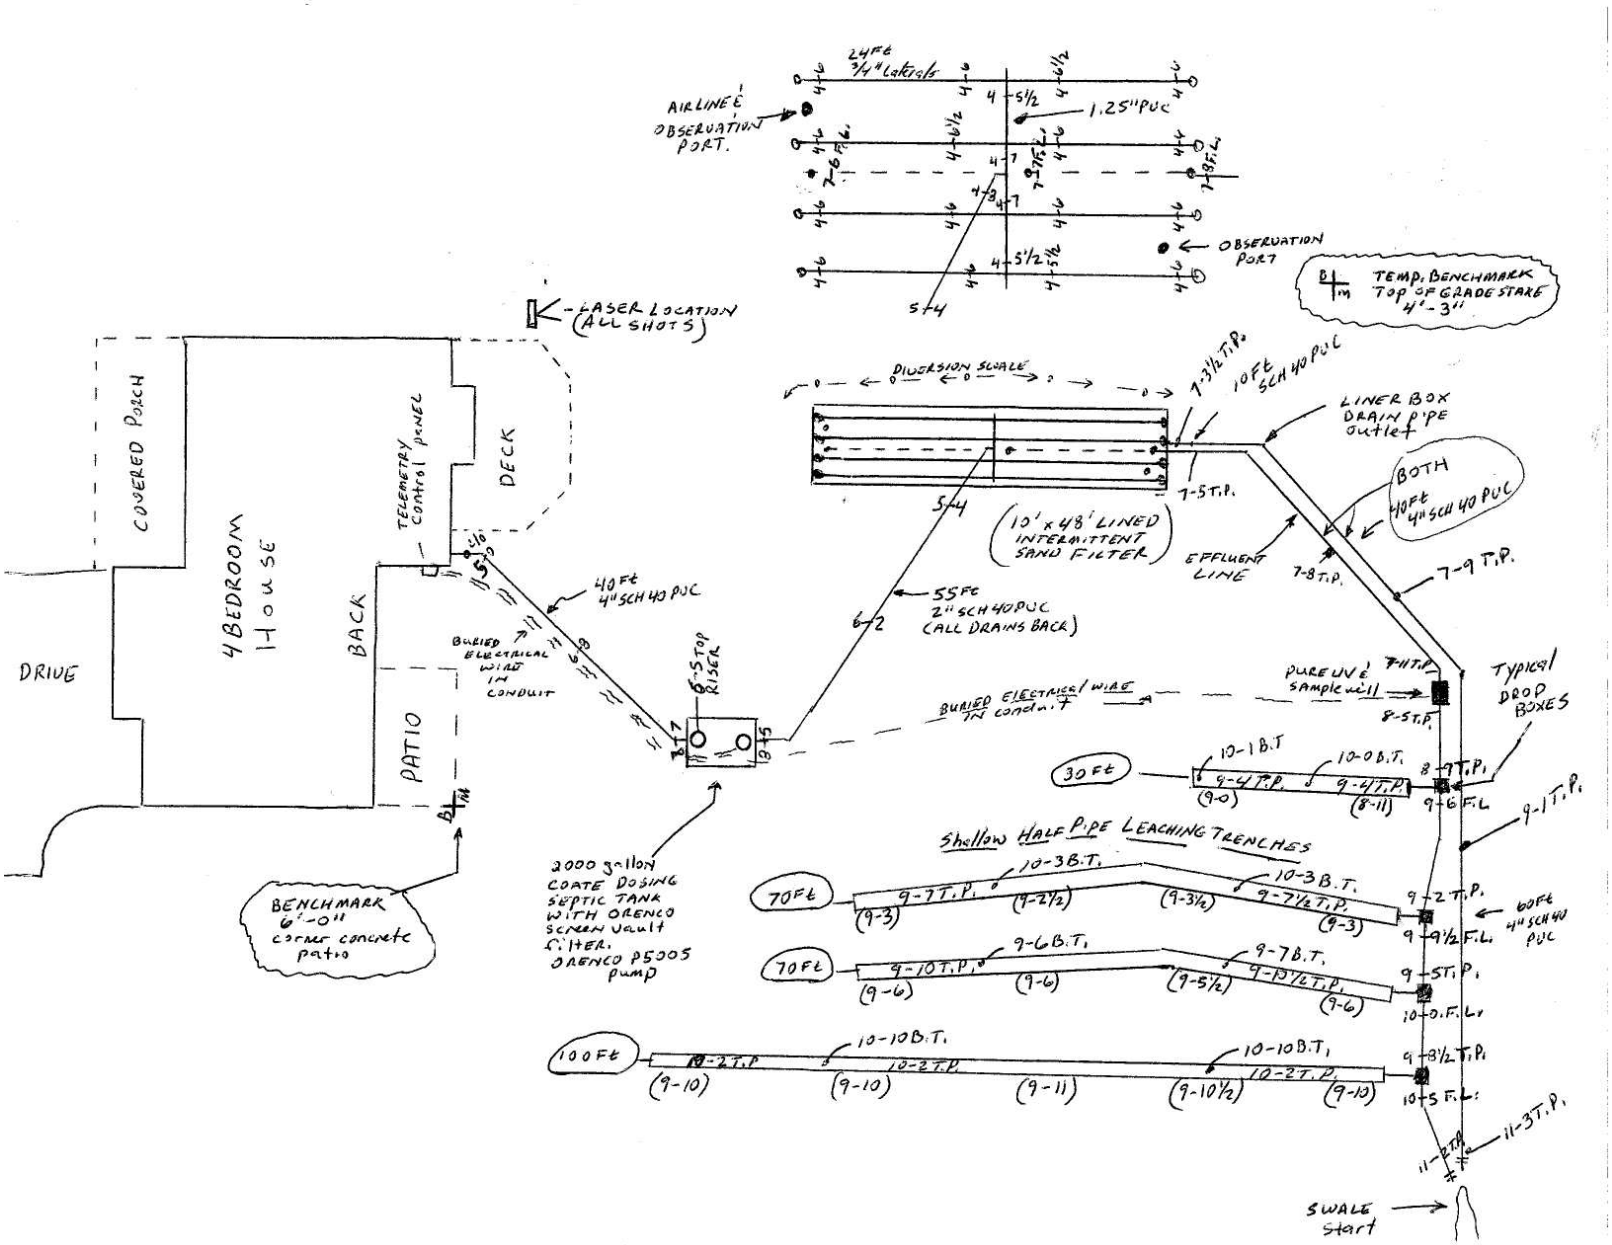
As-Built Drawing Example